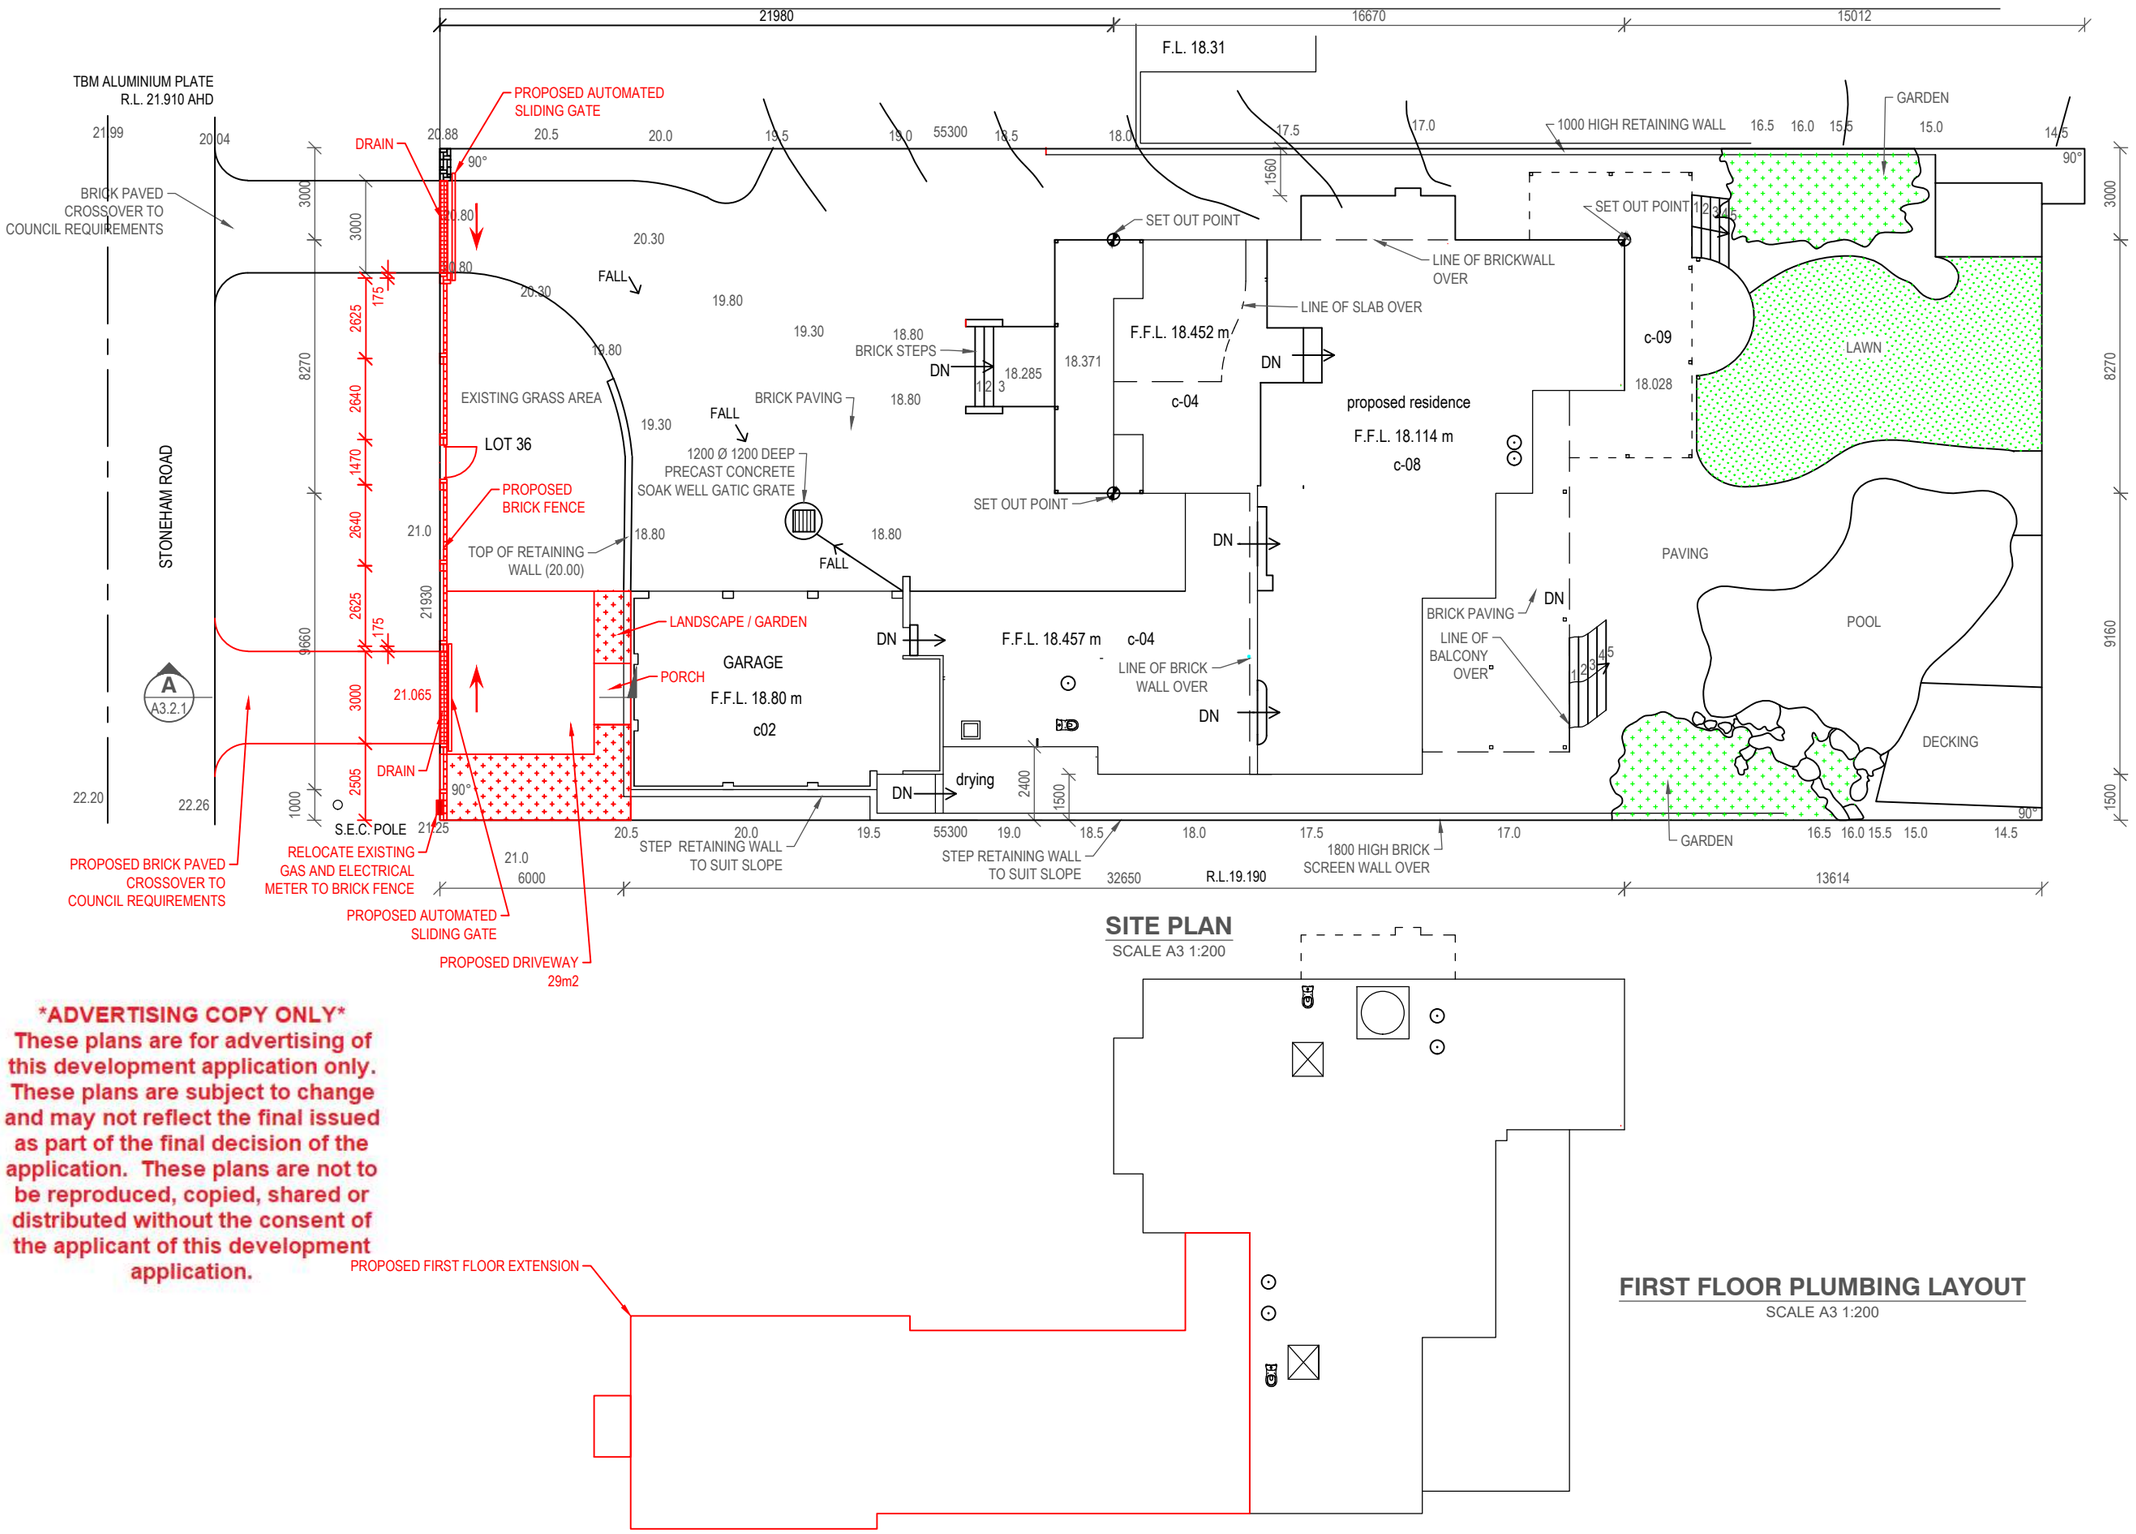


SITE PLAN

SCALE A3 1:200

FIRST FLOOR PLUMBING LAYOUT

SCALE A3 1:200

NORTH

ADVERTISING COPY ONLY

These plans are for advertising of this development application only. These plans are subject to change and may not reflect the final issued as part of the final decision of the application. These plans are not to be reproduced, copied, shared or distributed without the consent of the applicant of this development application.

Rev	Description	Date	App.
A	FOR DA APPROVAL	25.08.26	-
B	FOR DA APPROVAL. LANDSCAPE AREA AMENDED.	16.10.26	-

DTMT CONSTRUCTION CO.
29 Wellard Street Bibra Lake WA 6163
Tel : 08 9494 4000 Fax : 08 9494 4999
A.B.N. 46 960 821 956

Drawing Title:
PROPOSED RENOVATION
SITE PLAN

Address:
15 STONEHAM ROAD ATTADALE

PRELIMINARY

Reviewed : P.D.

Scale (A3) : 1: 200 | Date : 14.03.2014


Designed By : J.W. | Checked by : -

Drawing No: PDH / A1.1 | Revision: B

Document Set ID: 7569954
Version: 2, Version Date: 26/11/2026

Document Set ID: 7484894
Version: 1, Version Date: 01/09/2026

This information is provided from TechnologyOne ECM

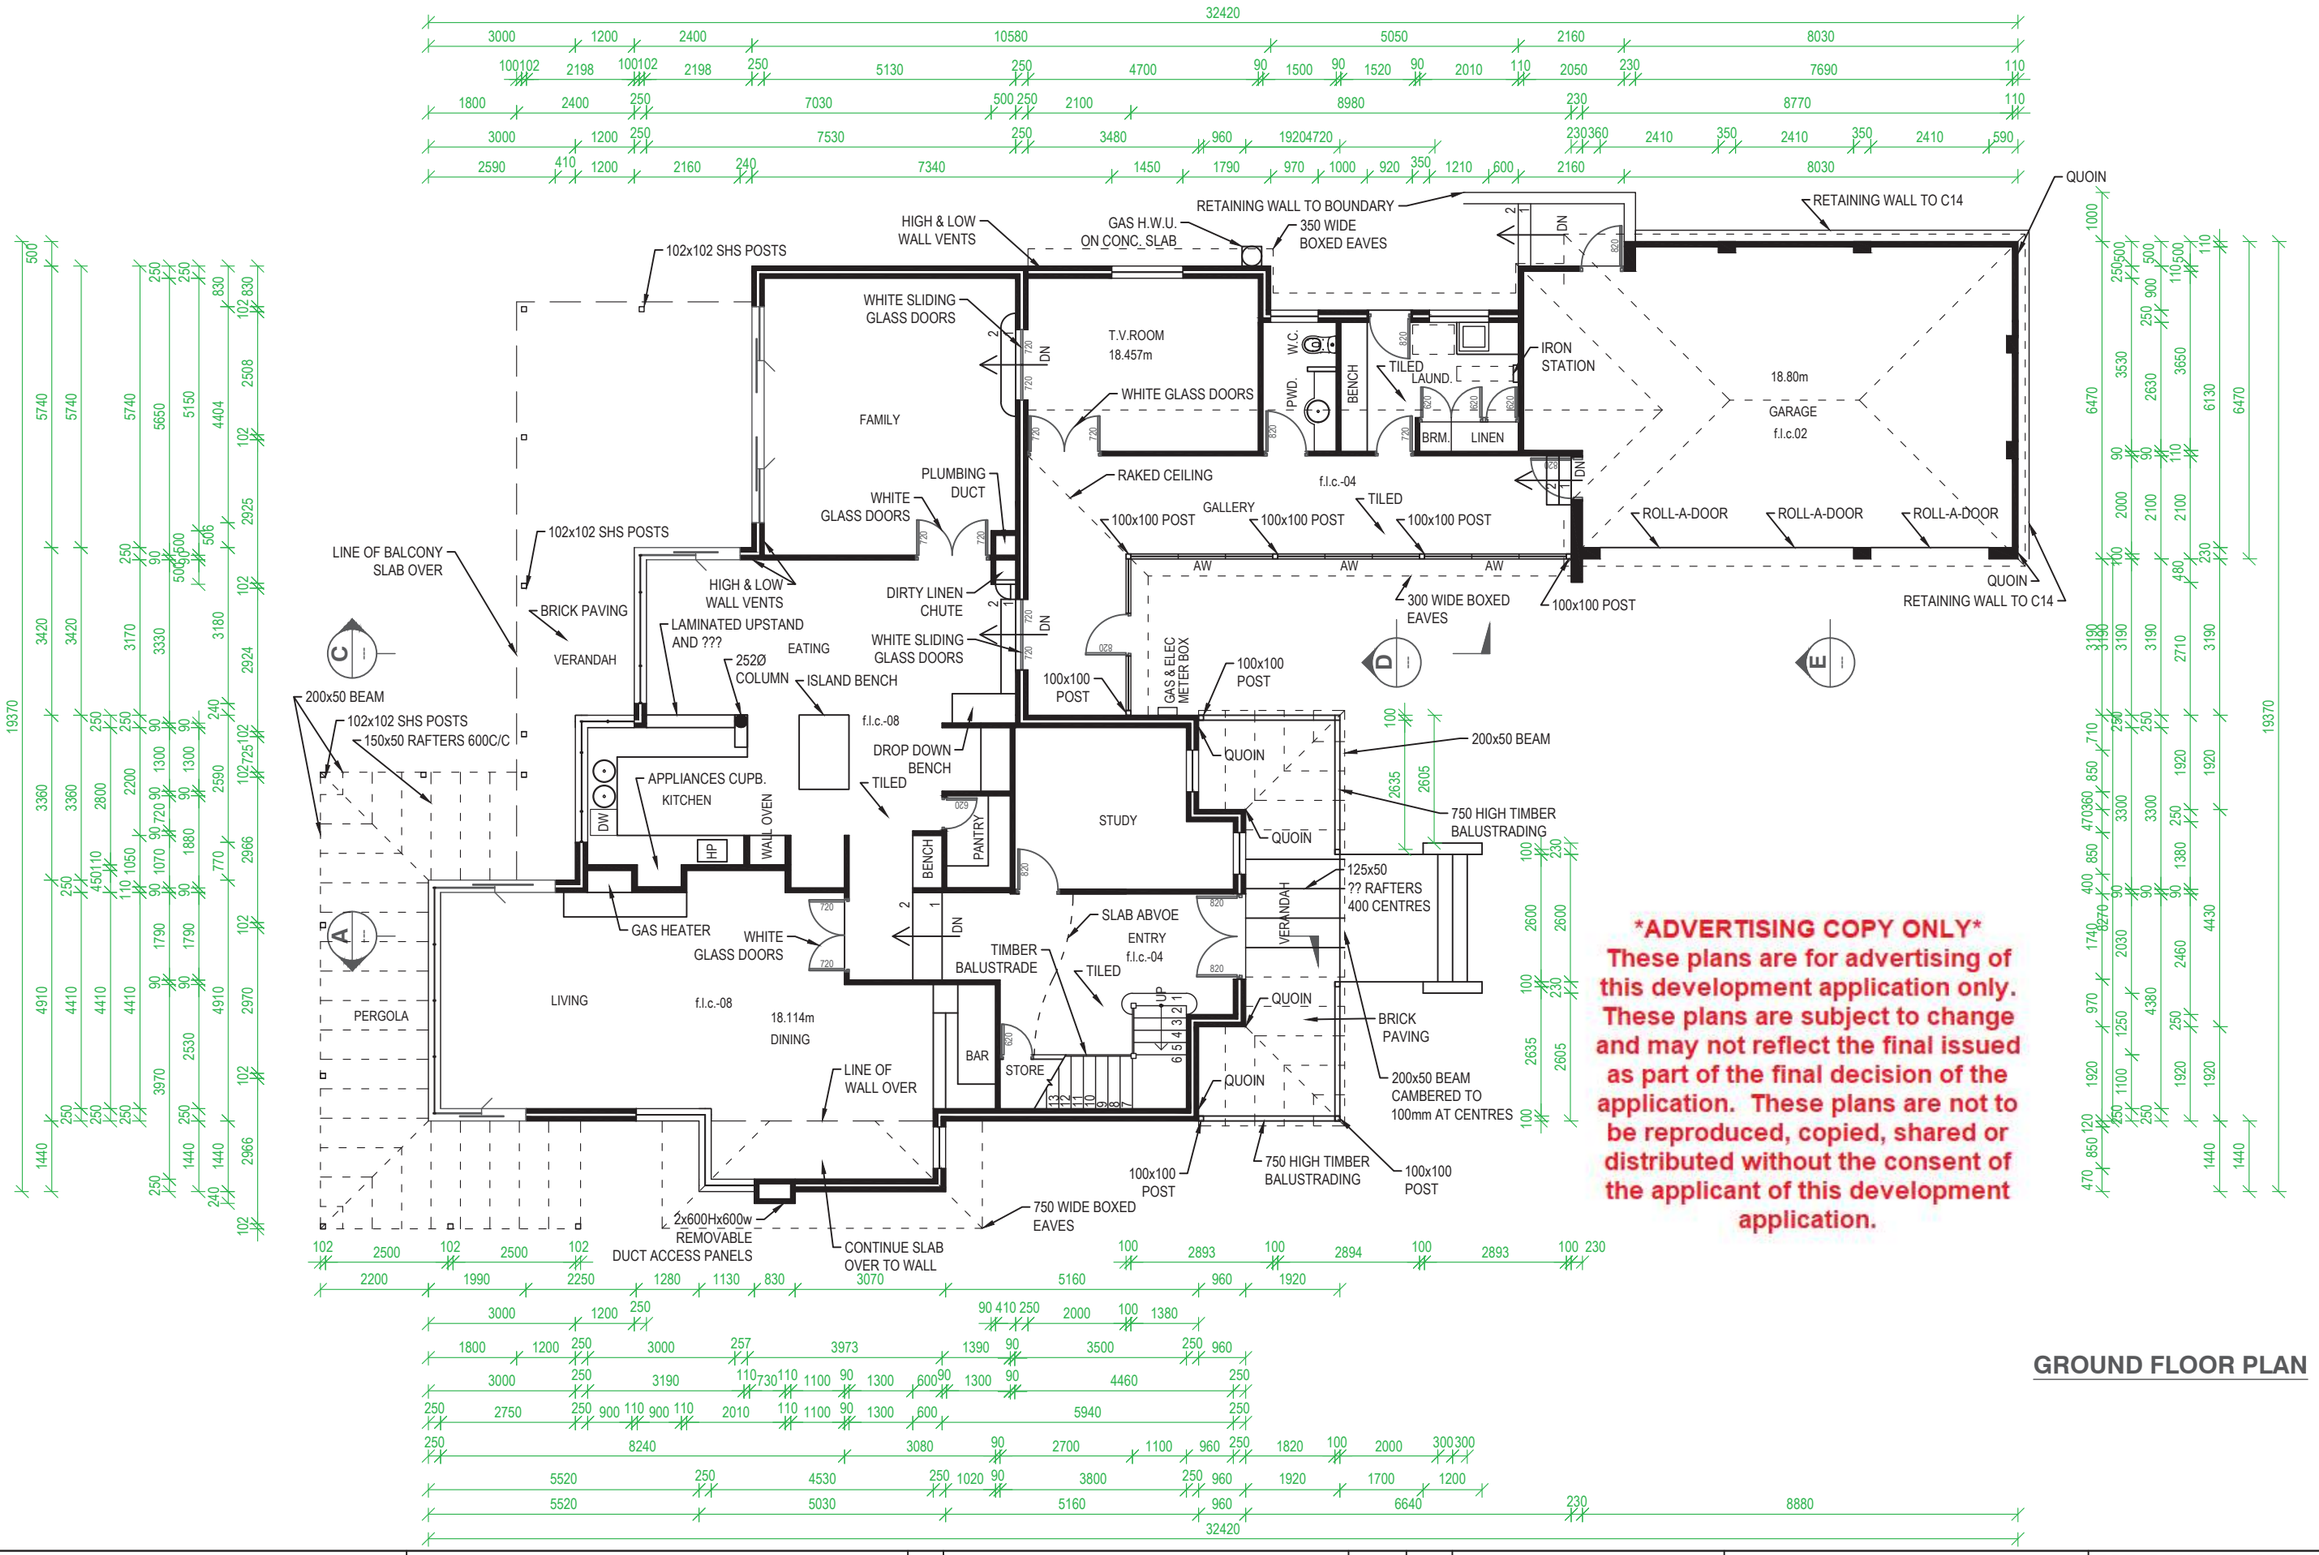

ADVERTISING COPY ONLY
These plans are for advertising of this development application only. These plans are subject to change and may not reflect the final issued as part of the final decision of the application. These plans are not to be reproduced, copied, shared or distributed without the consent of the applicant of this development application.

GROUND FLOOR PLAN

Rev	Description	Date	App.
0	AS CONSTRUCTED DRAWING	14.03.14	-

DTMT CONSTRUCTION CO.
29 Wellard Street Bibra Lake WA 6163
Tel : 08 9494 4000 Fax : 08 9494 4999
A.B.N. 46 960 821 956


Drawing Title: FLOOR PLAN 1 OF 2

Address: 15 STONEHAM ROAD ATTADALE

FOR CONSTRUCTION

Reviewed : P.D.	
Scale (A3) : 1: 150	Date : 14.03.2014
Designed By : J.W.	Checked by : -
Drawing No: PDH / A2.1	Revision: 0

Print Date: 29 September 2026, 9:41 am
Document Set ID: 7569954
Version: 2, Version Date: 26/11/2026

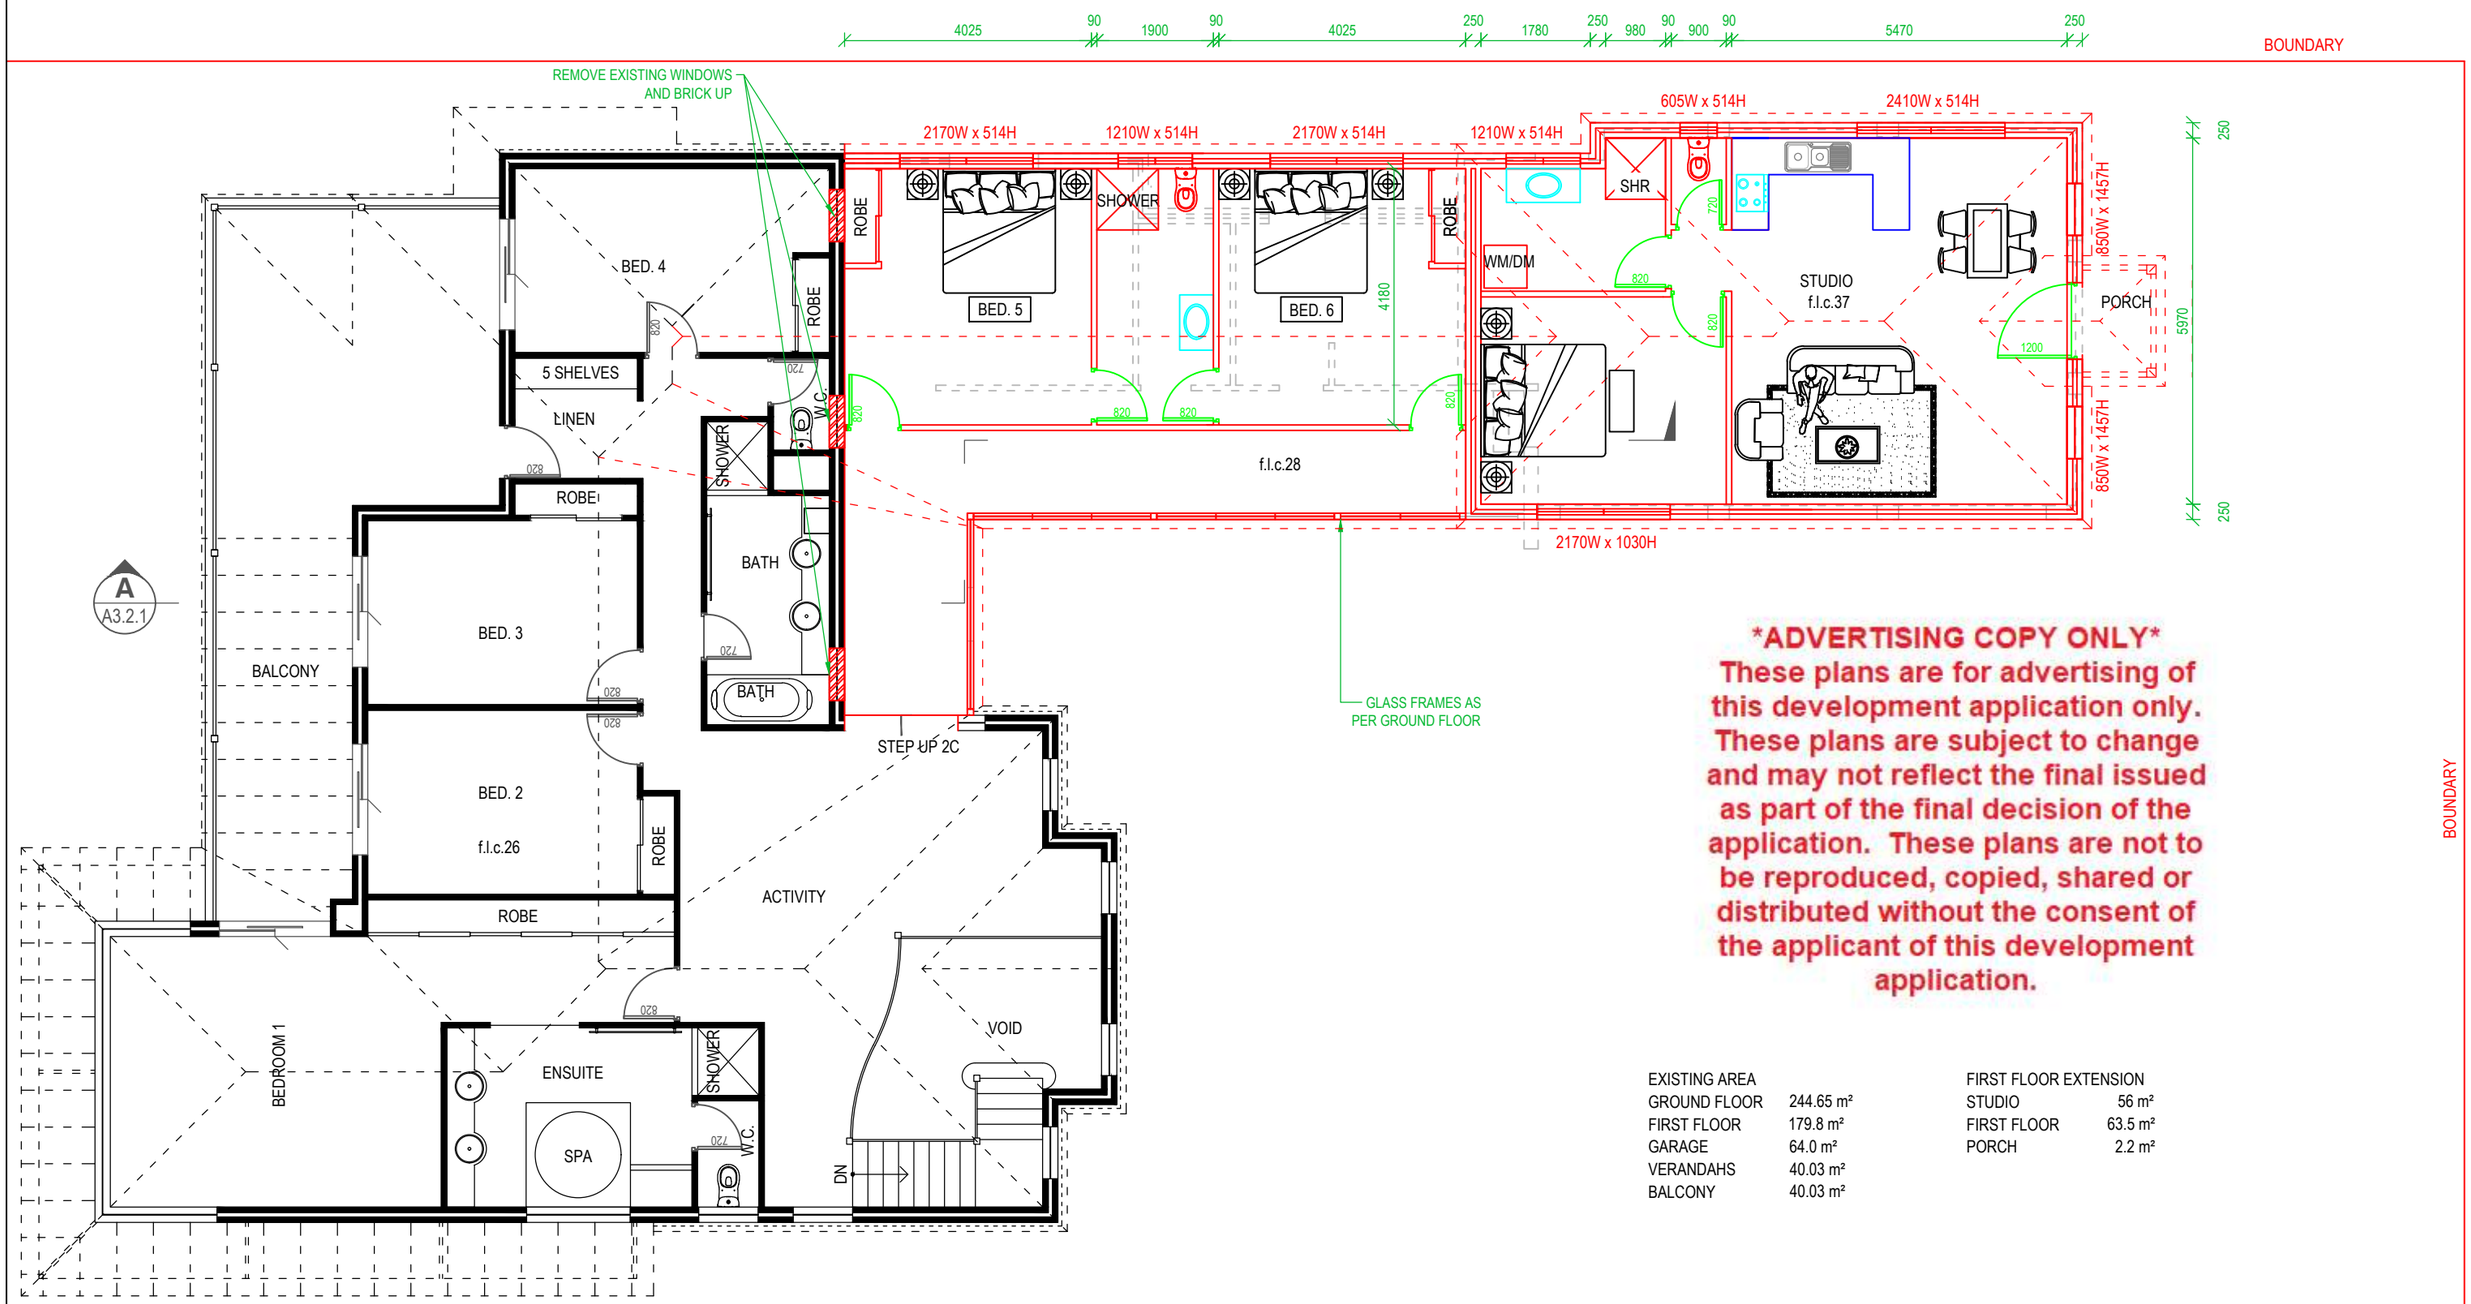

ADVERTISING COPY ONLY
These plans are for advertising of this development application only. These plans are subject to change and may not reflect the final issued as part of the final decision of the application. These plans are not to be reproduced, copied, shared or distributed without the consent of the applicant of this development application.

EXISTING AREA		FIRST FLOOR EXTENSION	
GROUND FLOOR	244.65 m²	STUDIO	56 m²
FIRST FLOOR	179.8 m²	FIRST FLOOR	63.5 m²
GARAGE	64.0 m²	PORCH	2.2 m²
VERANDAHS	40.03 m²		
BALCONY	40.03 m²		

BOUNDARY

BOUNDARY

FIRST FLOOR PLAN

Rev	Description	Date	App.
A	PROPOSED RENOVATION	04.08.26	-
B	FOR DA APPLICATION. BOUNDARIES ADDED	16.10.26	-
C	FOR DA APPLICATION.	28.10.26	-

DTMT CONSTRUCTION CO.
29 Wellard Street Bibra Lake WA 6163
Tel : 08 9494 4000 Fax : 08 9494 4999
A.B.N. 46 960 821 956

Drawing Title:
PROPOSED RENOVATION
FIRST FLOOR PLAN

Address:
15 STONEHAM ROAD ATTADALE

PRELIMINARY


Reviewed : P.D.

Scale (A3) : 1: 100 | Date : 14.03.2014

Designed By : J.W. | Checked by : -


Drawing No: PDH / A2.2.1 | Revision: C

Document Set ID: 7569954
Version: 2, Version Date: 26/11/2026

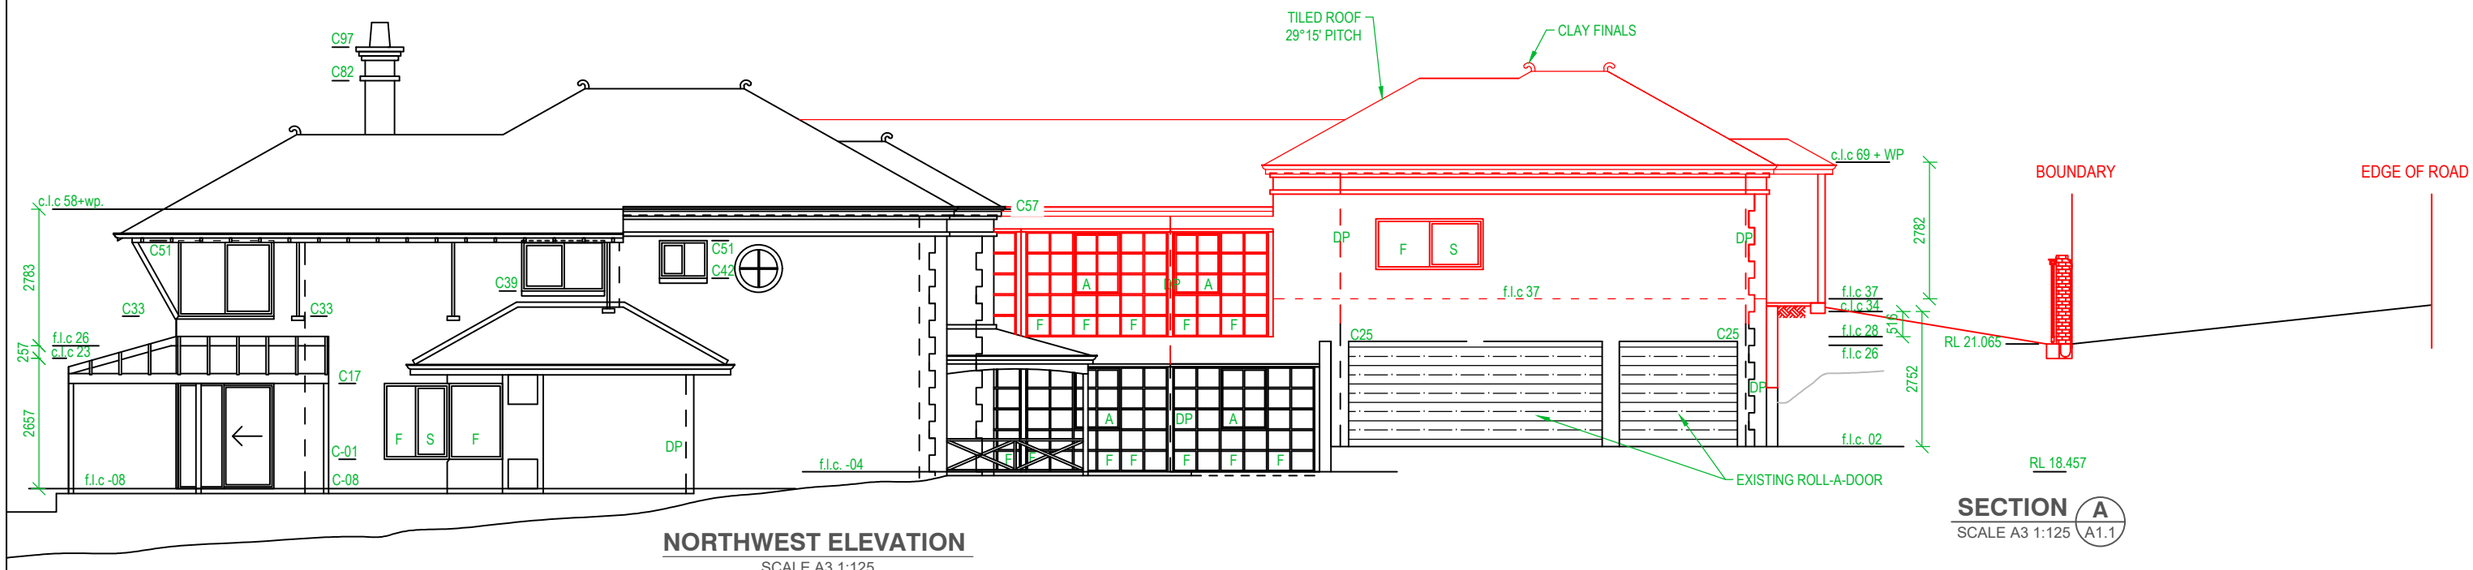

NORTHWEST ELEVATION
SCALE A3 1:125

SECTION A
SCALE A3 1:125 A1.1

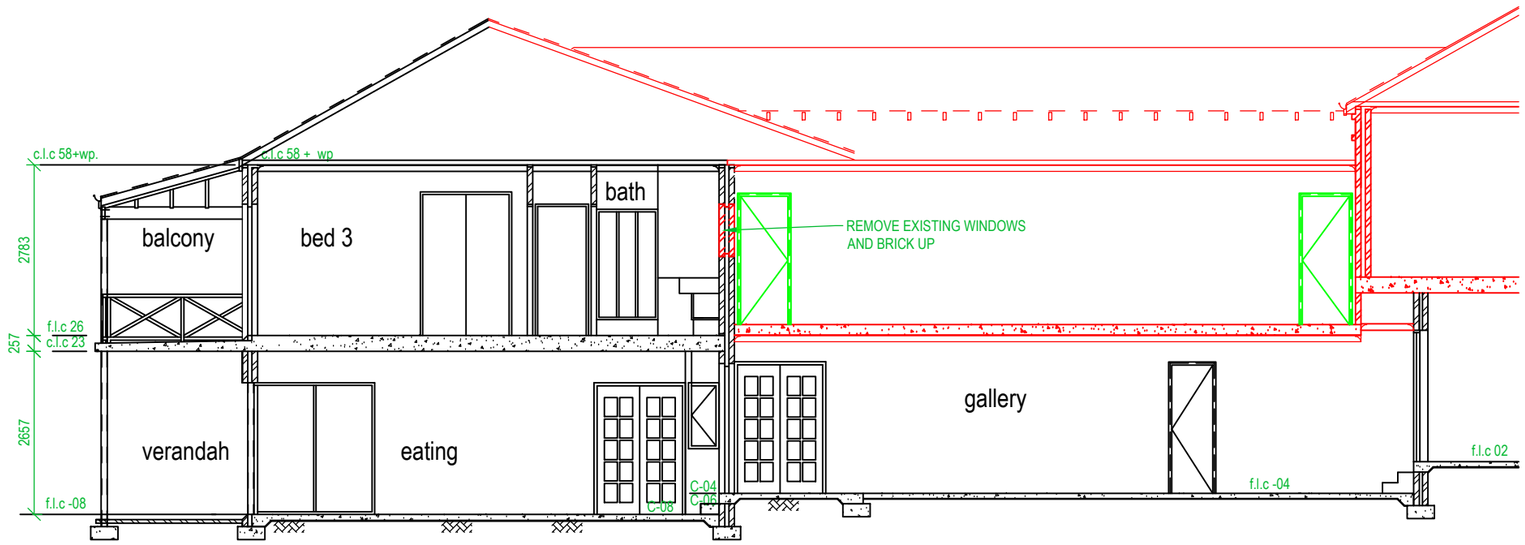

SECTION A
SCALE A3 1:100 A2.2.1

ADVERTISING COPY ONLY
These plans are for advertising of this development application only. These plans are subject to change and may not reflect the final issued as part of the final decision of the application. These plans are not to be reproduced, copied, shared or distributed without the consent of the applicant of this development application.

Rev	Description	Date	App.
A	FOR DA APPLICATION	31.08.26	-
B	FOR DA APPLICATION.	16.10.26	-
C	FOR DA APPLICATION.	28.10.26	-

DTMT CONSTRUCTION CO.
29 Wellard Street Bibra Lake WA 6163
Tel : 08 9494 4000 Fax : 08 9494 4999
A.B.N. 46 960 821 956

Drawing Title:
PROPOSED RENOVATION
NORTHWEST ELEVATION & SECTION

Address:
15 STONEHAM ROAD ATTADALE

PRELIMINARY

Reviewed : P.D.


Scale (A3) : 1: 100 | Date : 14.03.2014

Designed By : J.W. | Checked by : -


Drawing No: PDH / A3.2.1 | Revision: C

Document Set ID: 7569954
Version: 2, Version Date: 26/11/2026

ADVERTISING COPY ONLY
These plans are for advertising of this development application only. These plans are subject to change and may not reflect the final issued as part of the final decision of the application. These plans are not to be reproduced, copied, shared or distributed without the consent of the applicant of this development application.

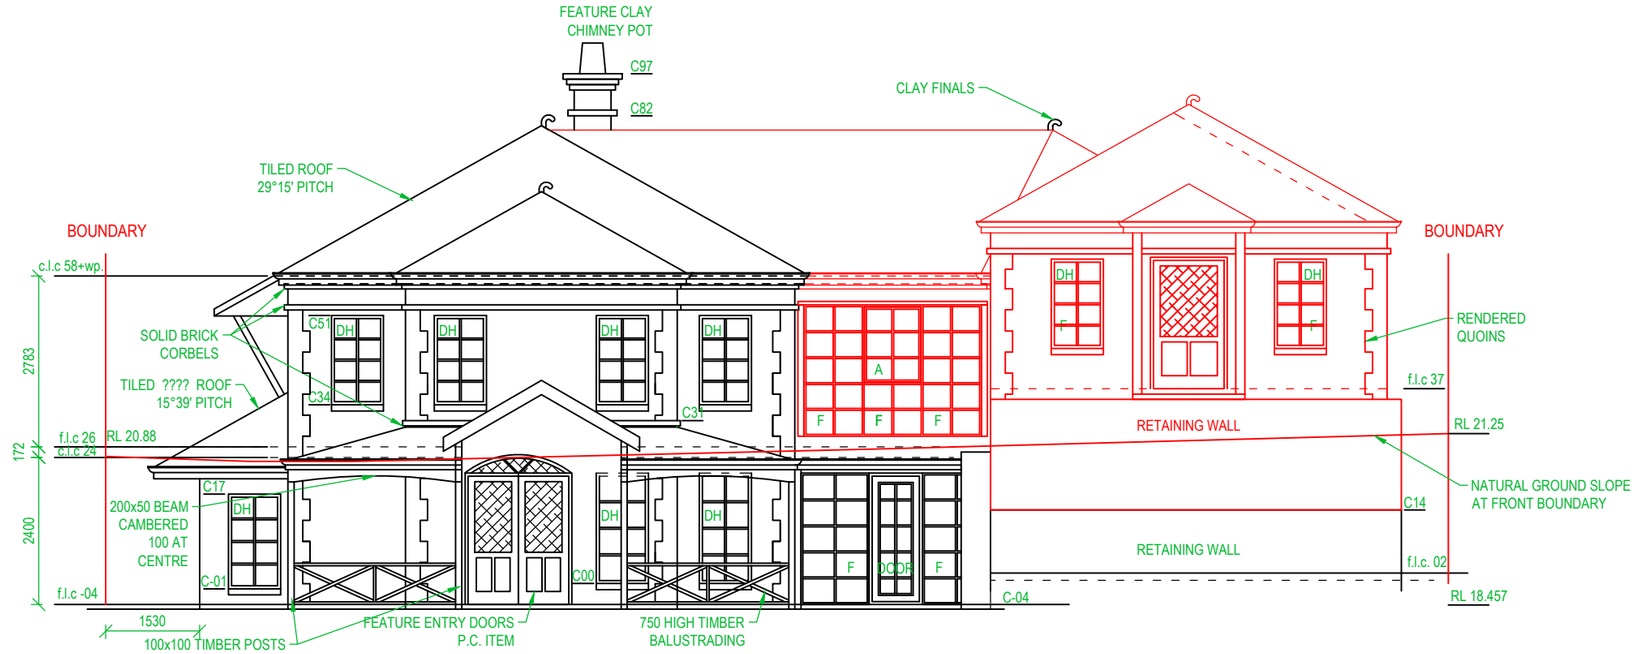

SOUTHWEST ELEVATION
SCALE A3 1:100

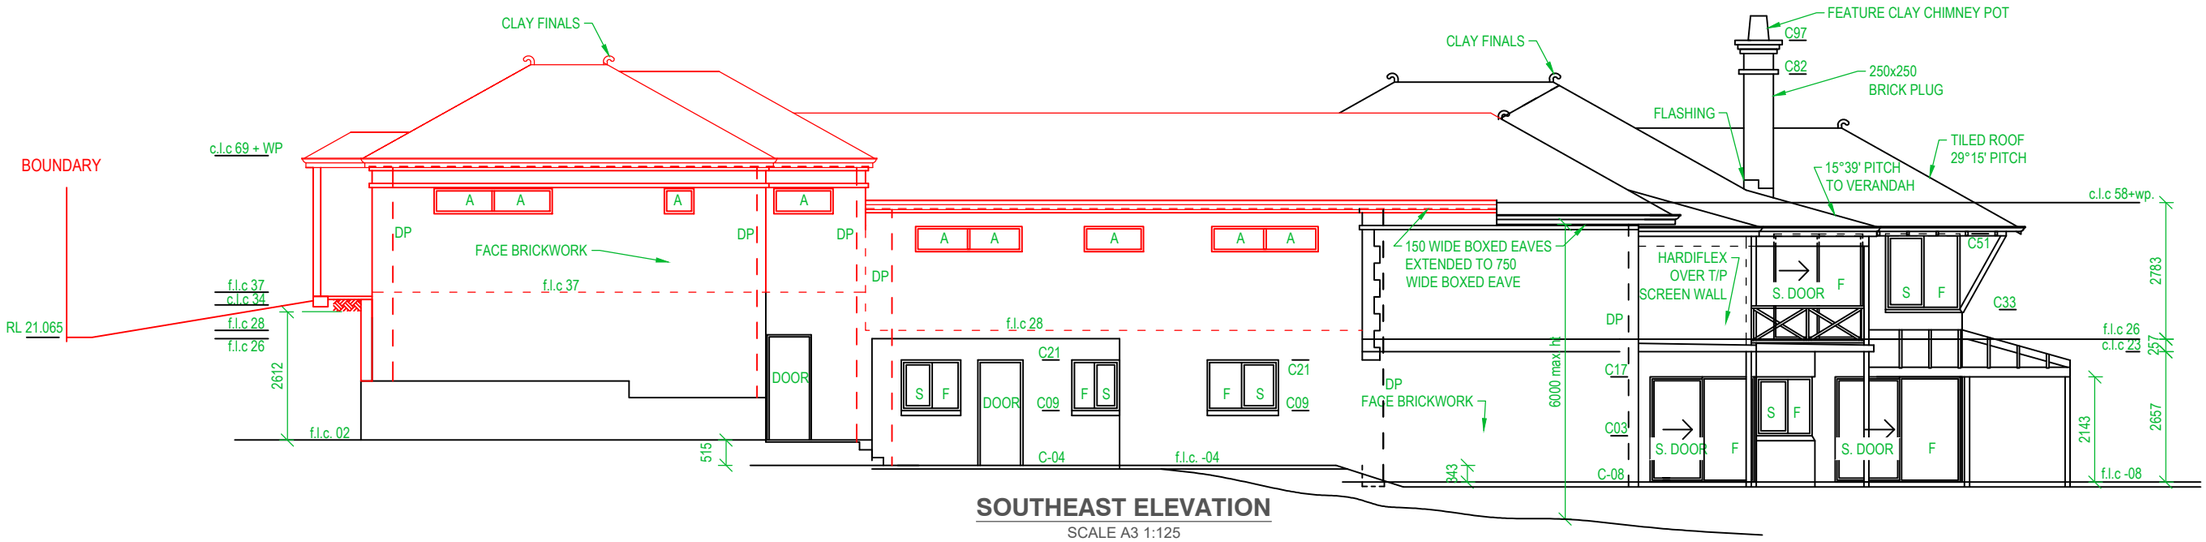

SOUTHEAST ELEVATION
SCALE A3 1:125

Rev	Description	Date	App.
A	FOR DA APPLICATION	20.10.26	-
B	FOR DA APPLICATION.	28.10.26	-

DTMT CONSTRUCTION CO.
29 Wellard Street Bibra Lake WA 6163
Tel : 08 9494 4000 Fax : 08 9494 4999
A.B.N. 46 960 821 956

Drawing Title:
PROPOSED RENOVATION
SOUTHWEST & SOUTHEAST ELEVATION

Address:
15 STONEHAM ROAD ATTADALE

PRELIMINARY

Reviewed : P.D.
Scale (A3) : 1: 100 | Date : 20.10.2026
Designed By : J.W. | Checked by : -
Drawing No: PDH / A3.1.1 | Revision: B

Document Set ID: 7569954
Version: 2, Version Date: 26/11/2026

Document Set ID: 7484815
Version: 1, Version Date: 01/09/2026

This information is provided from TechnologyOne ECM



ADVERTISING COPY ONLY
These plans are for advertising of this development application only. These plans are subject to change and may not reflect the final issued as part of the final decision of the application. These plans are not to be reproduced, copied, shared or distributed without the consent of the applicant of this development application.

OVERSHADOWING AREA ON 21st JUNE AT 12 NOON ONTO ADJOINING LOT

AREA	111.12m²
LOT AREA	1013.0m²
%	11.0 %

Rev	Description	Date	App.
A	FOR DA APPLICATION	31.08.26	-

DTMT CONSTRUCTION CO.
29 Wellard Street Bibra Lake WA 6163
Tel : 08 9494 4000 Fax : 08 9494 4999
A.B.N. 46 960 821 956

Drawing Title:
PROPOSED RENOVATION
OVERSHADOWING

Address:
15 STONEHAM ROAD ATTADALE

PRELIMINARY

Reviewed : P.D.	
Scale (A3) : 1: 150	Date : 31.08.2026
Designed By : J.W.	Checked by : -
Drawing No: PDH / A5.1	Revision: A

Print Date: 29 September 2026, 9:41 am

Document Set ID: 7569954
Version: 2, Version Date: 26/11/2026